


NOTES

HORIZONTAL CONTROL BASED ON THE ADDISON AIRPORT CONTROL NETWORK.
 THE AIRPORT BOUNDARIES SHOWN ON THIS DRAWING ARE BASED ON A CALCULATED LOCATION FROM INFORMATION SHOWN ON THE FINAL PLAT OF ADDISON AIRPORT. THIS DRAWING IS NOT INTENDED TO REPRESENT A BOUNDARY SURVEY FOR THIS PORTION OF THE AIRPORT.
 THIS SURVEY WAS PREPARED FOR PLANNING PURPOSES. ADDITIONAL FIELD SURVEYS MAY BE REQUIRED FOR DEVELOPMENT OF THE SITE.
 SUBSURFACE UTILITIES NOT LOCATED AS A PART OF THIS SURVEY.

LEGEND

- ⊗ Power Pole
- ⊠ Light Pole
- ⊙ Water Meter
- ⊕ Water Valve
- ⊞ Gas Meter
- ⊖ Hydrant
- ⊚ Cleanout
- ⊡ Sign
- ⊛ Electric Meter
- ⊜ Monitoring Well
- ⊝ Telephone Pedestal

D.A.R.T.

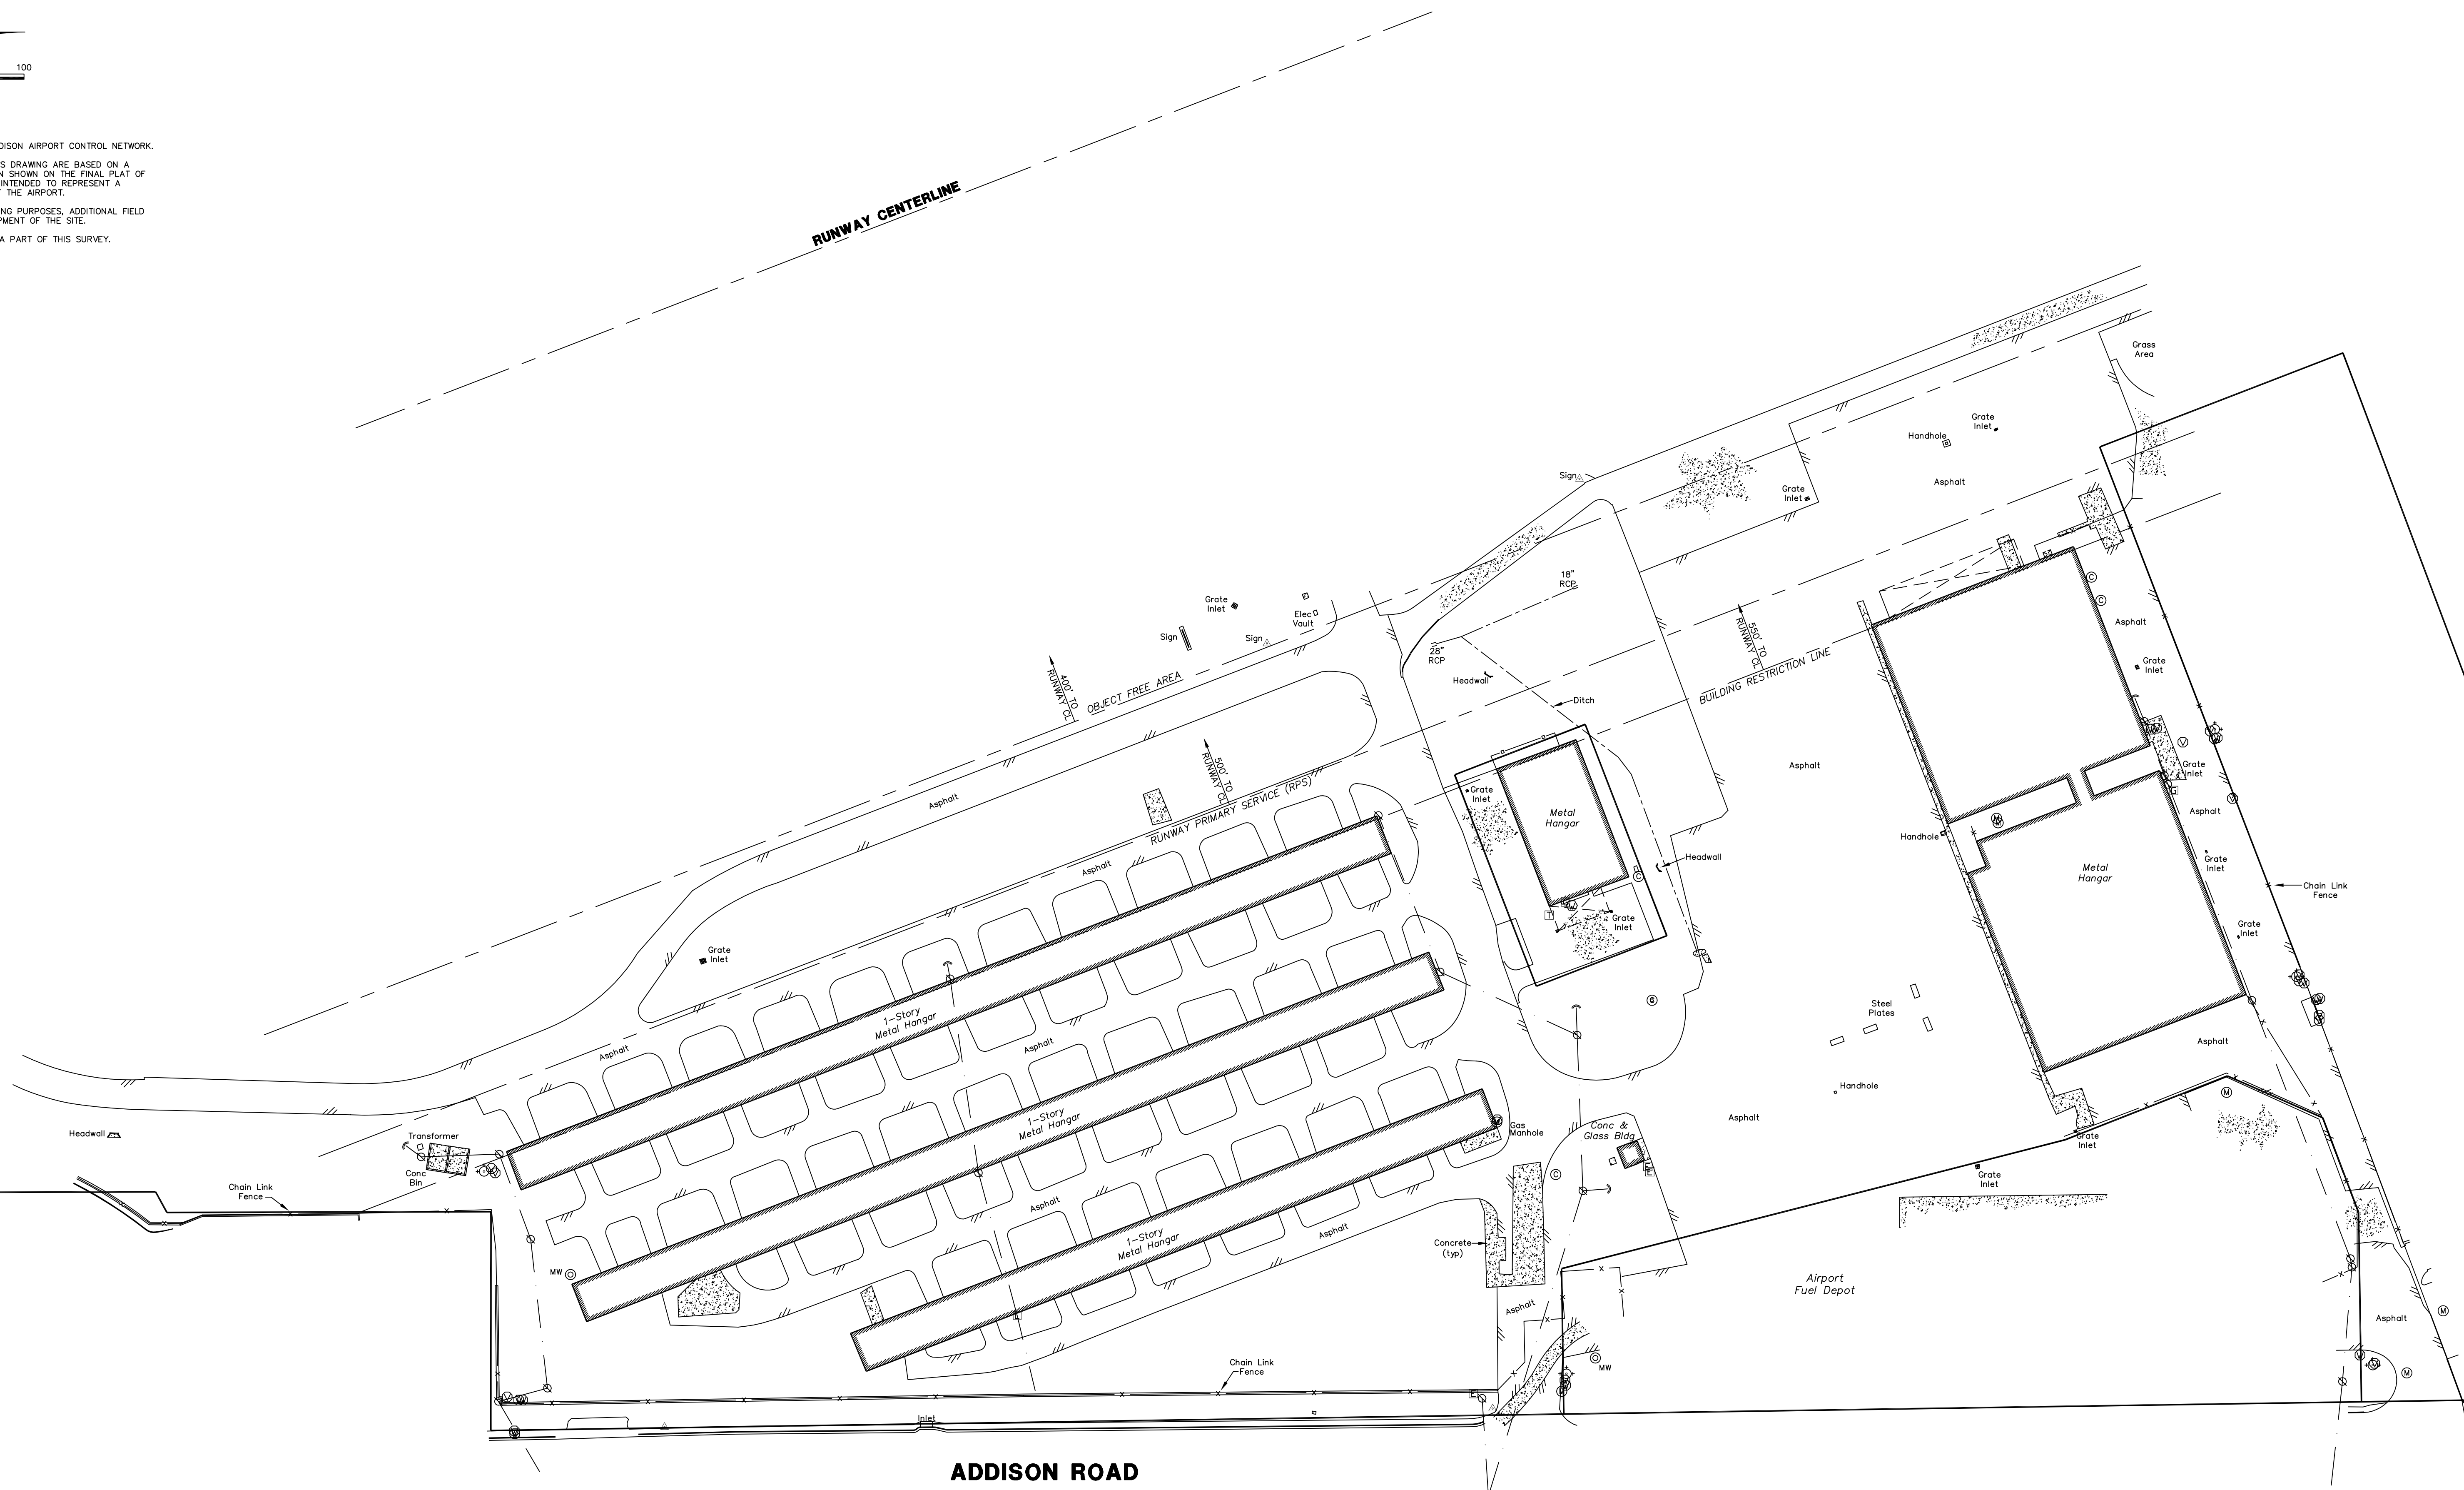

DRAWN BY: B.D.S./CAD
 CHECKED BY: B.D.S.
 SCALE: 1" = 60'
 DATE: FEB. 20, 2014
 JOB NO. 19000T

AS-BUILT SURVEY
 A PART OF
ADDISON AIRPORT
 TOWN OF ADDISON
 DALLAS COUNTY, TEXAS

Sparr Surveys
 2573 C.R. 722
 McKinney, Texas 75069
 (214) 544-2297

TBPLS FIRM No. 10059300
 Copyright © 2014 Sparr Surveys. All rights reserved.